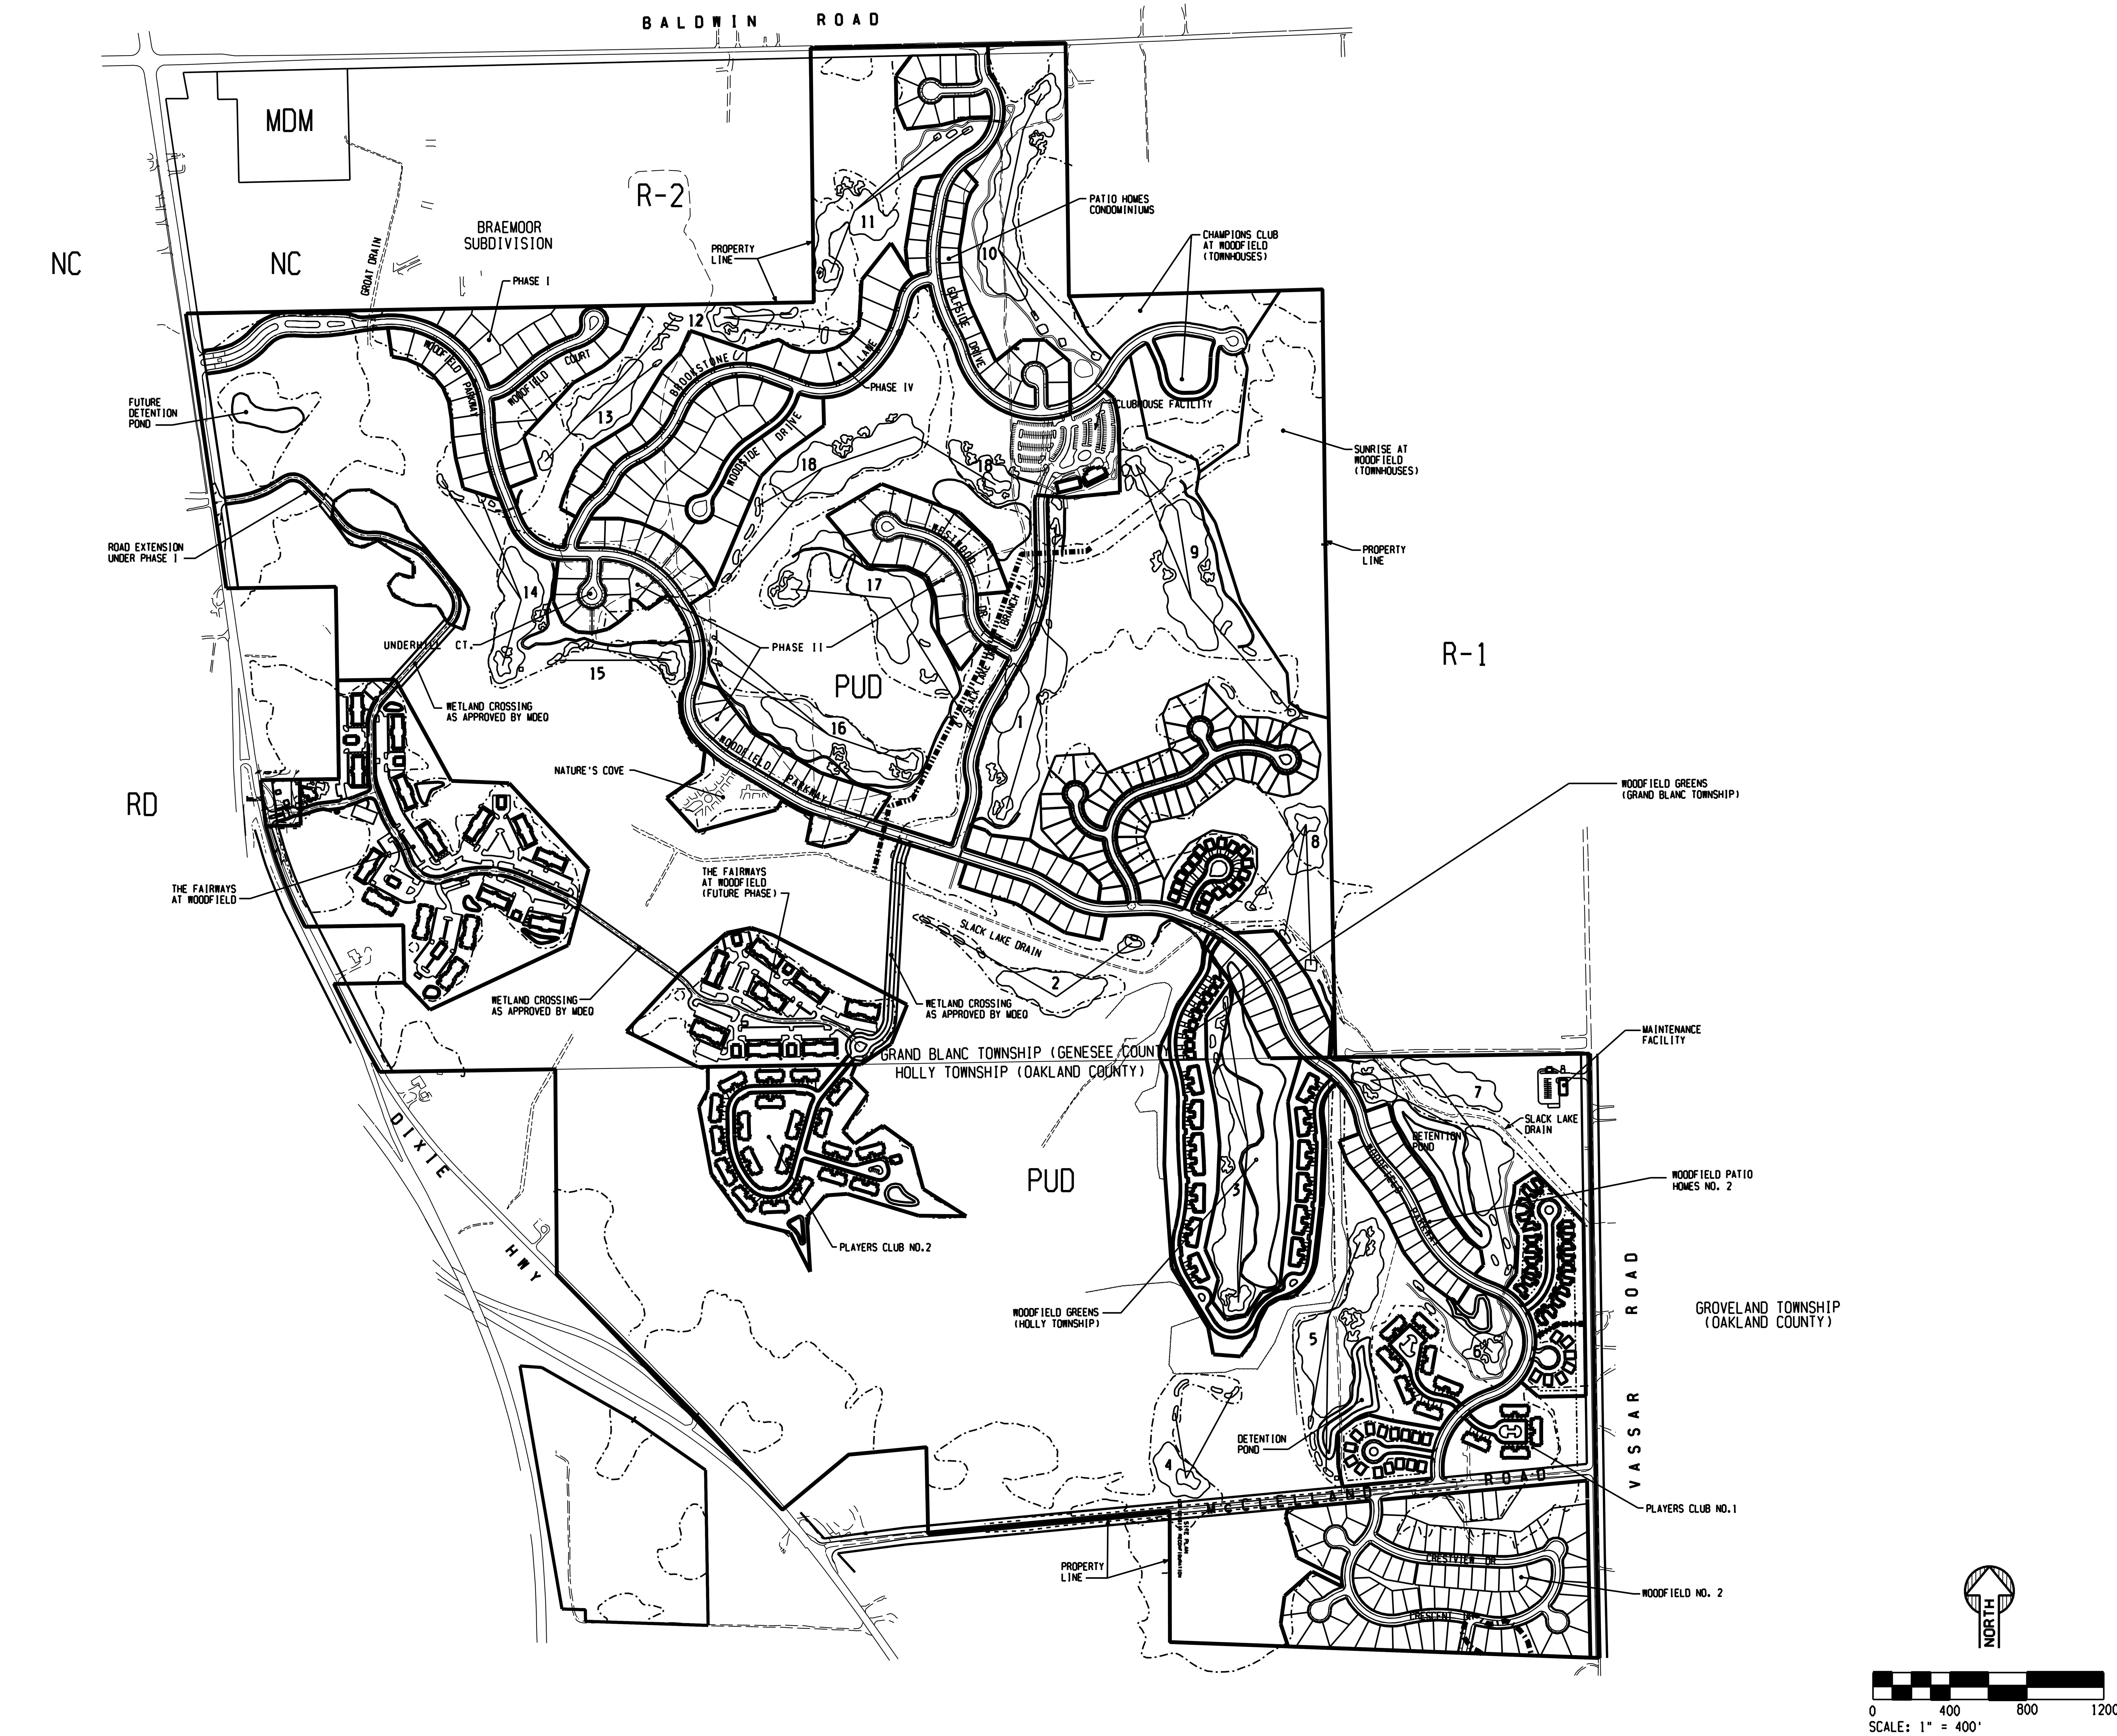

NOTES:

1. TOPOGRAPHICAL SURVEY AND CONTOURING PROVIDED BY AIR-LAND SURVEYS, INC. JOB #P89145.
2. WETLAND BOUNDARY WAS REFLAGGED BY KING & MCGREGOR ENVIRONMENTAL INC. IN JUNE OF 2001 AND APPROVED BY THE MICHIGAN DEPARTMENT OF ENVIRONMENTAL QUALITY (MDEQ). THE DEVELOPER HAS PROVIDED A CONSERVATION EASEMENT TO THE MDEQ FOR PRESERVATION OF THE WETLAND AREA.
3. SSOE HAS SURVEYED AND TIED IN ALL WETLAND FLAGS AS SET BY KING & MCGREGOR ENVIRONMENTAL INC.

SAND TRAPS	
TEES & GREENS	
FAIRWAYS	
WETLAND	
PHASES UNDER CONSTRUCTION OR COMPLETED	

ZONING LEGEND

R-1	SINGLE FAMILY RESIDENTIAL
R-2	SINGLE FAMILY RESIDENTIAL
MDM	MEDIUM DENSITY MULTIPLE
RD	RESEARCH AND DEVELOPMENT
NC	NEIGHBORHOOD COMMERCIAL
PUD	PLANNED UNIT DEVELOPMENT

NO.	DATE	SUBJECT
	07-07-05	AS-BUILTS GB & HOLLY TWP APPR.
	03-09-05	BUILDING NO. REVISIONS
	11-17-04	GB TWP-SINGLE FAM SEWER TAPS
	10-09-03	REV. SANITARY/WATER LEADS
	10-08-03	ISSUED TO OCDC - SESC
	08-22-03	REISSUED TO AGENCIES
	08-14-03	REISSUED TO AGENCIES
	07-01-03	ISSUED TO AGENCIES

REVISION OR ISSUE

DRAWN	FITZGERALD
CHECKED	
DESIGNED	
DEPT.MGR.	HOLMBLADE
PROJ.MGR.	HOLMBLADE

SEAL

SSOE, INC.
ENGINEERS ARCHITECTS PLANNERS LAND SURVEYORS
1050 WILSHIRE DR. - SUITE #260
TROY, MICHIGAN 48084 TEL. 248-643-6222

JOB TITLE

WOODFIELD
PLANNED UNIT DEVELOPMENT

DRAWING TITLE

WOODFIELD GREENS
OVERALL SITE PLAN

PROJECT NUMBER 03-5050-00

SHEET C01 OF

DRAWING NUMBER